

Section

NOTE:
 1. DISTANCE TAKEN FROM SPU AS-BUILT 776-47-20
 1" = 5'
 scale 5 0 5 10 feet

30% SUBMITTAL



FEDAID:
 SOME DATA ON RECORD DRAWINGS IS BASED UPON INFORMATION PROVIDED BY THE CONSTRUCTION CONTRACTOR TO THE CITY OF RENTON. THE CORRECTNESS TO THIS DATA HAS NOT BEEN VERIFIED.



33301 9th Avenue South, Suite 300
 Federal Way, Washington 98003-2600
 (206) 431-2300 Fax: (206) 431-2250


NO.	REVISION	BY	DATE	APPR

SCALE: 1"=20'
 VERTICALLY: 1"=5'
 HORIZONTALLY: 1"=20'/100'





STRANDER BOULEVARD EXTENSION
 PHASE 3
 SPU 60" WATER LINE AT UPRR

DATE: 2/5/2018
 DRAWING NO: FIG 1
 SHEET: 01

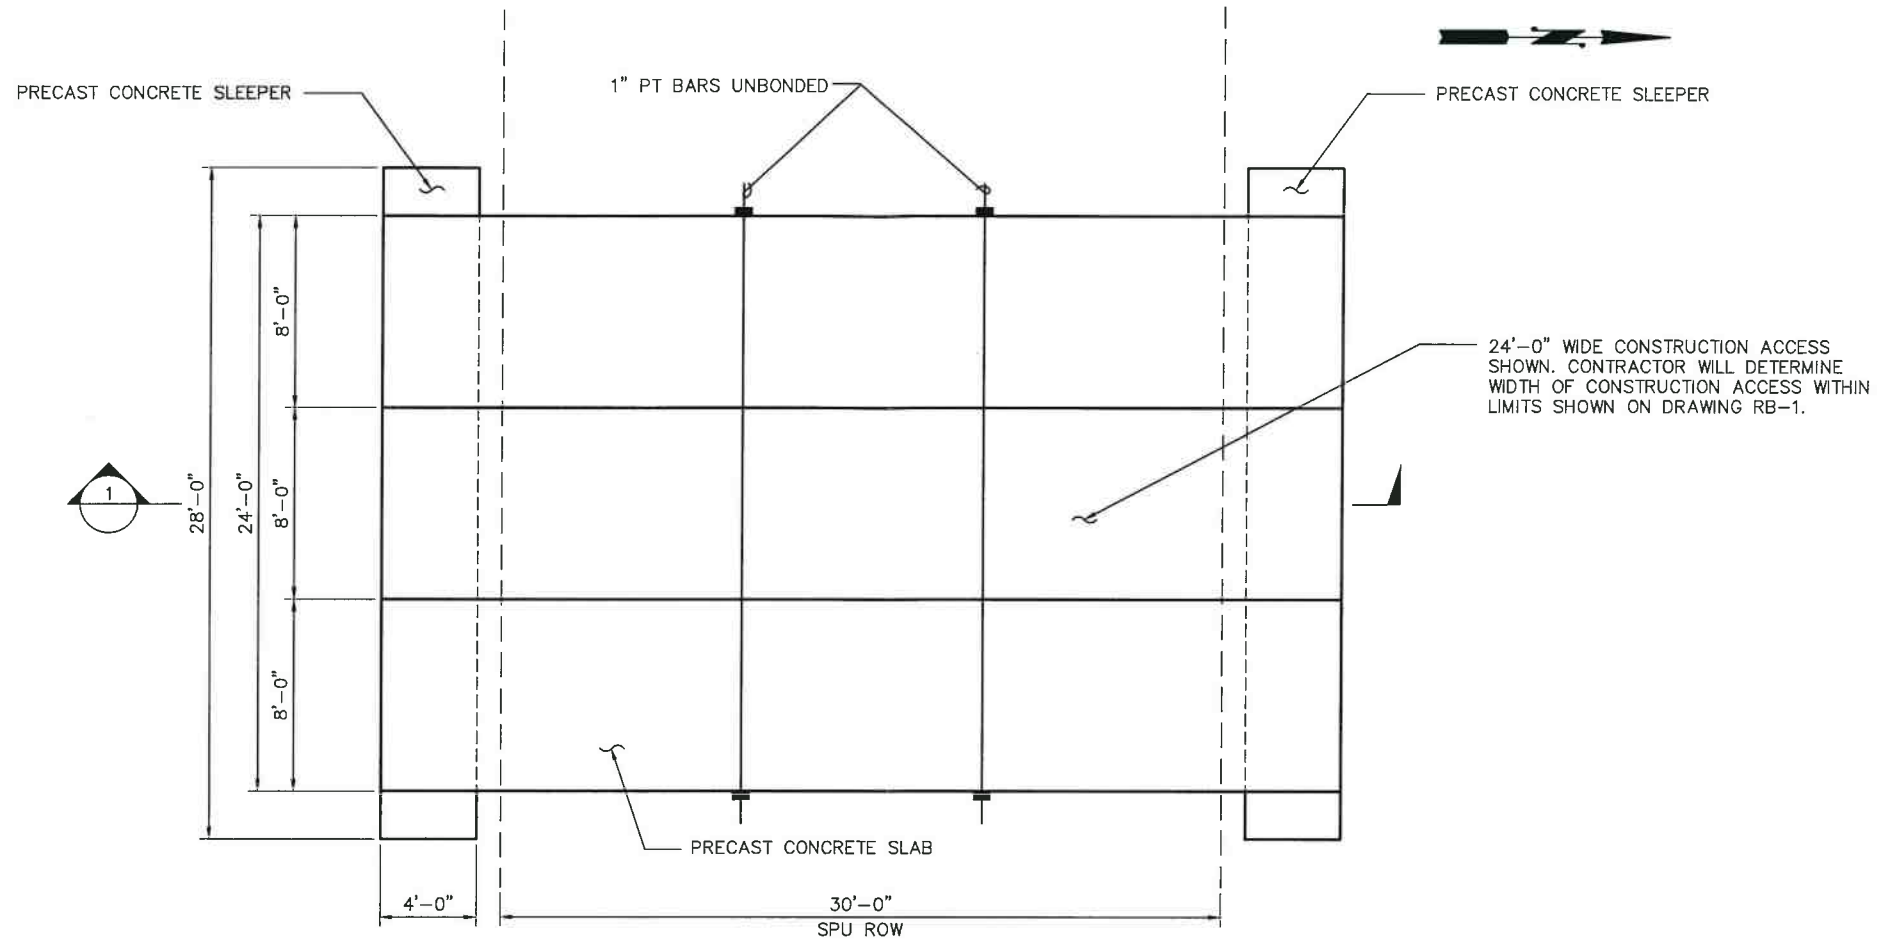

A PLAN
SCALE: 1/4" = 1'-0"

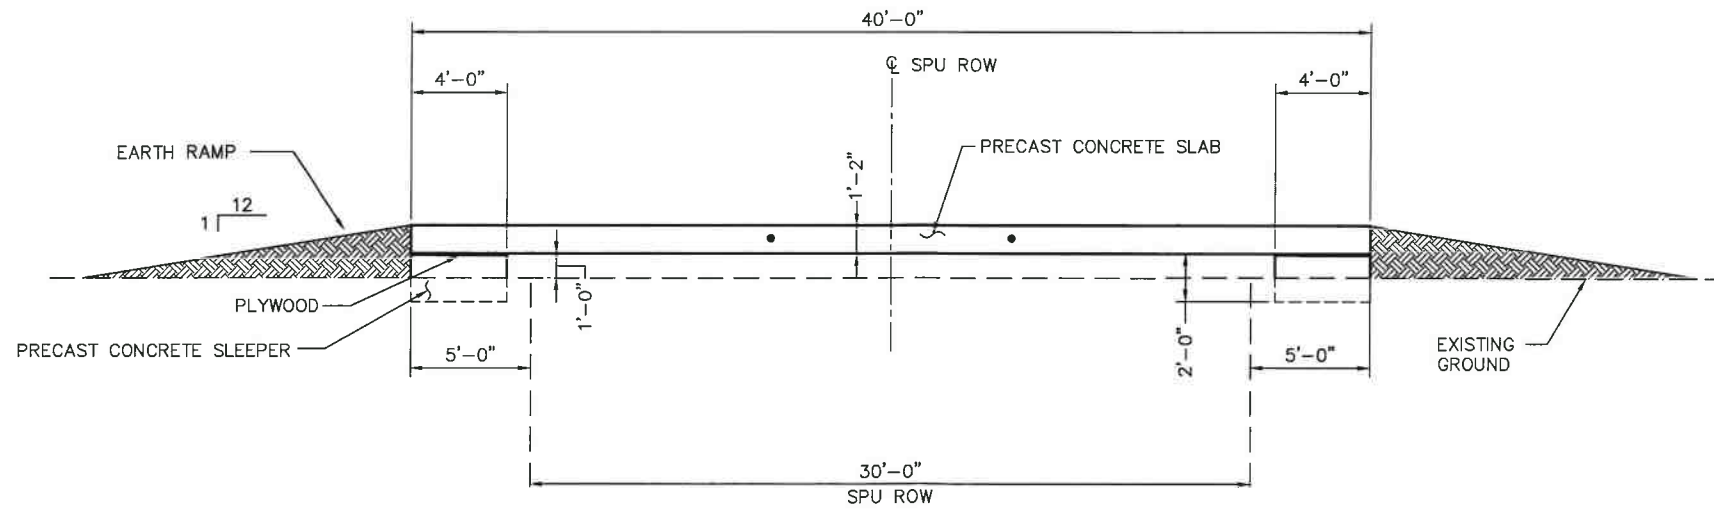


1 PROFILE
SCALE: 1/4" = 1'-0"

FEDAID:
SOME DATA ON RECORD DRAWINGS IS BASED UPON INFORMATION PROVIDED BY THE CONSTRUCTION CONTRACTOR TO THE CITY OF RENTON. THE CORRECTNESS TO THIS DATA HAS NOT BEEN VERIFIED.





NO.	REVISION	BY	DATE	APPR

SCALE: 1"=20'
VERTICAL: 1/4"=1'-0"
HORIZONTAL: 1/8"=1'-0"

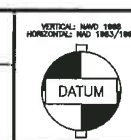

STRANDER BOULEVARD EXTENSION
PHASE 3
SPU 60" WATER LINE AT UPRR

FIG-2

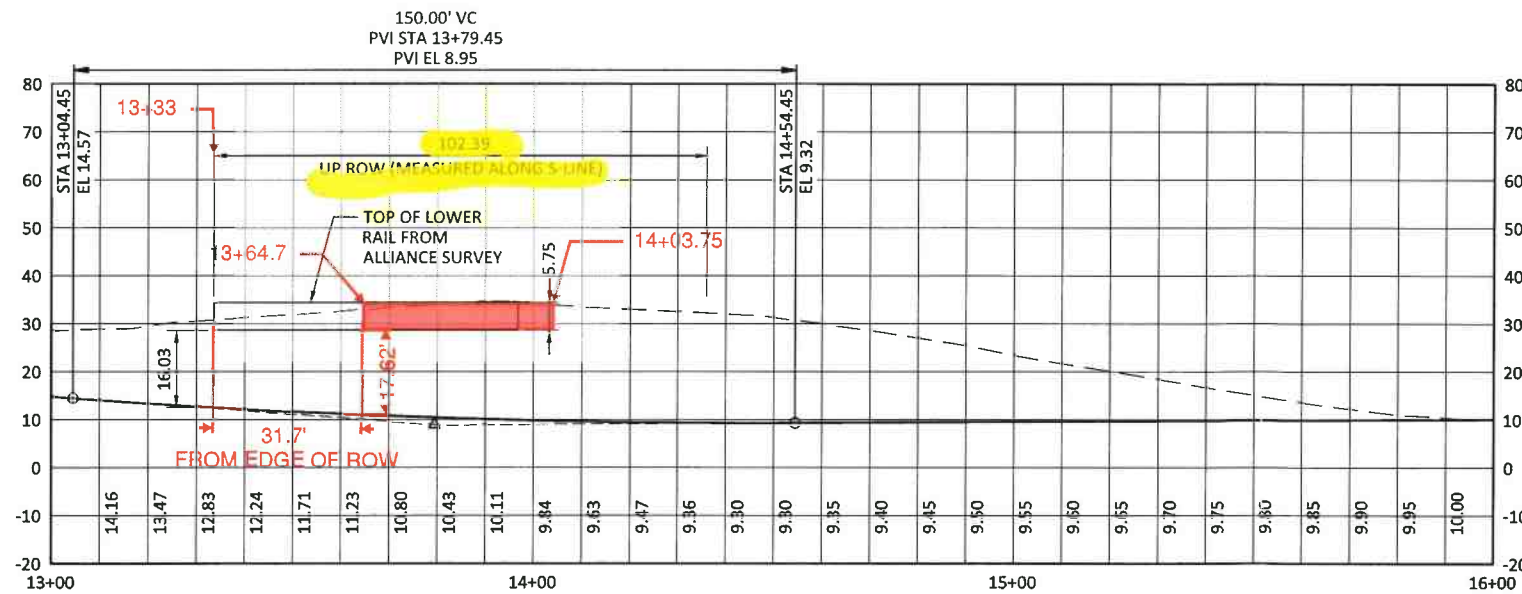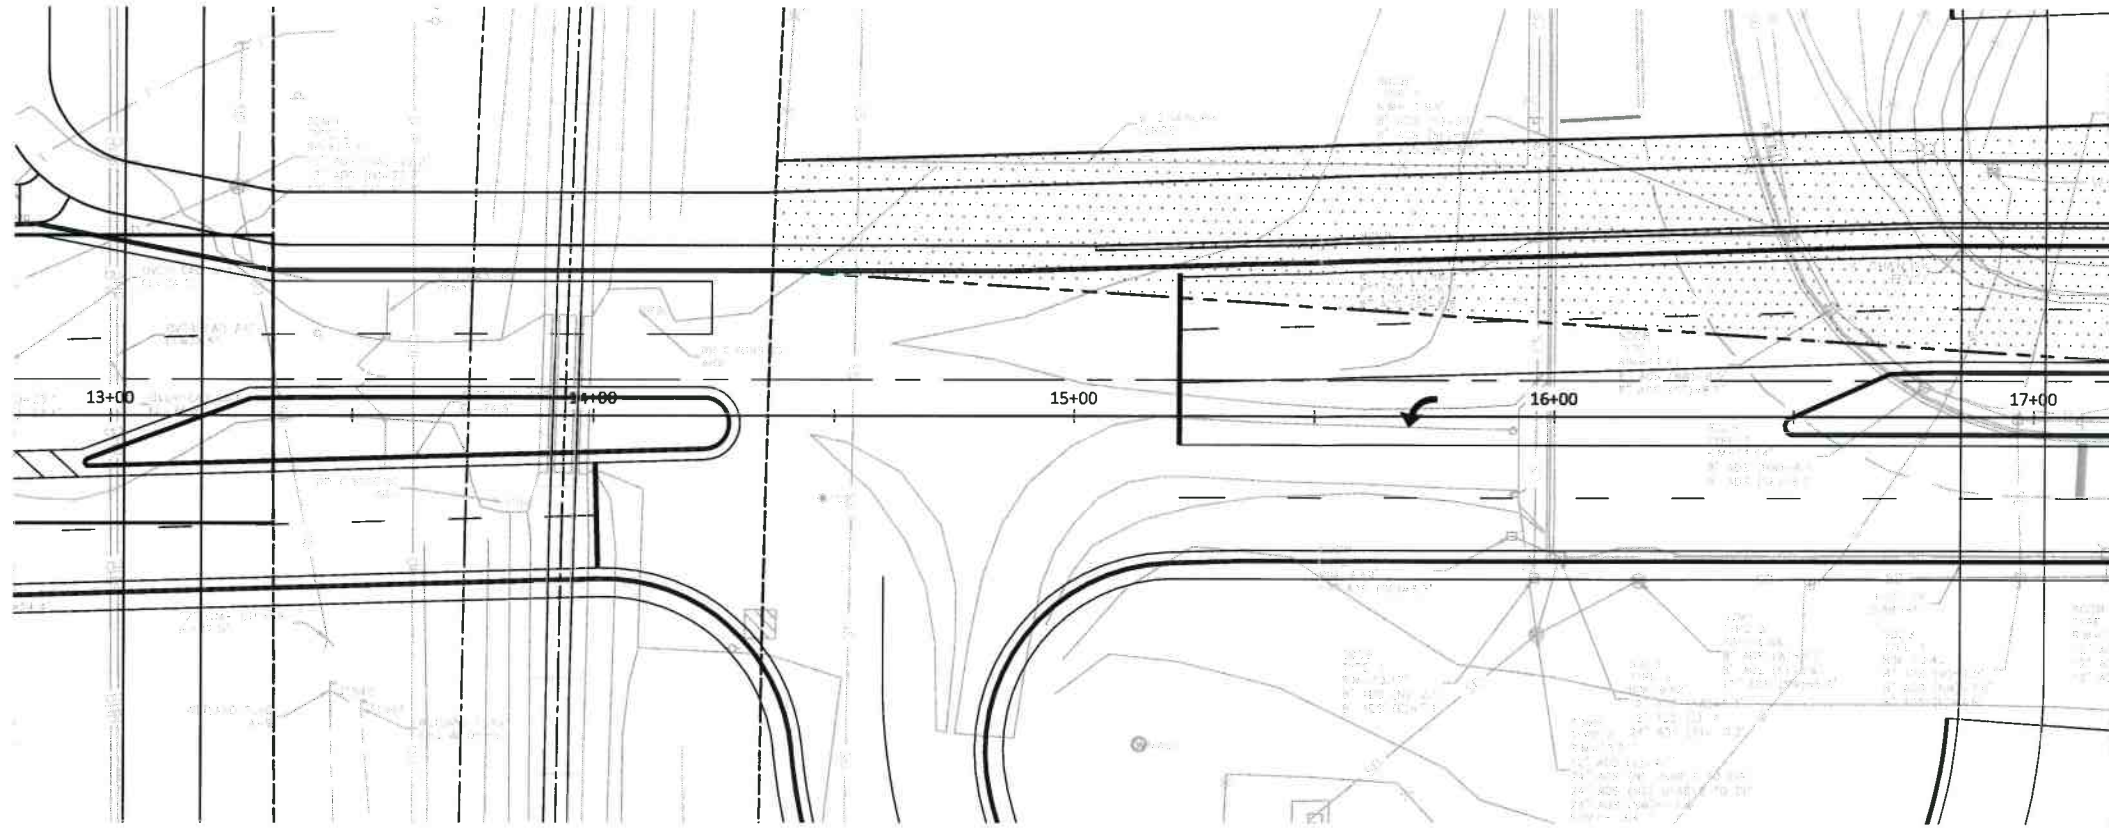

Profile S (2)

FEDAID:
SOME DATA ON RECORD DRAWINGS IS BASED UPON INFORMATION PROVIDED BY THE CONSTRUCTION CONTRACTOR TO THE CITY OF RENTON. THE CORRECTNESS TO THIS DATA HAS NOT BEEN VERIFIED.




NO.	REVISION	BY	DATE	APPR

DESIGNED:	
DRAWN:	
CHECKED:	
APPROVED:	

SCALE: 1"=20'
VERTICAL: AS SHOWN
HORIZONTAL: 1/8"=20'



DATE:	
FIELDWORK:	
DATE:	
DRAWING NO.:	
SHEET:	

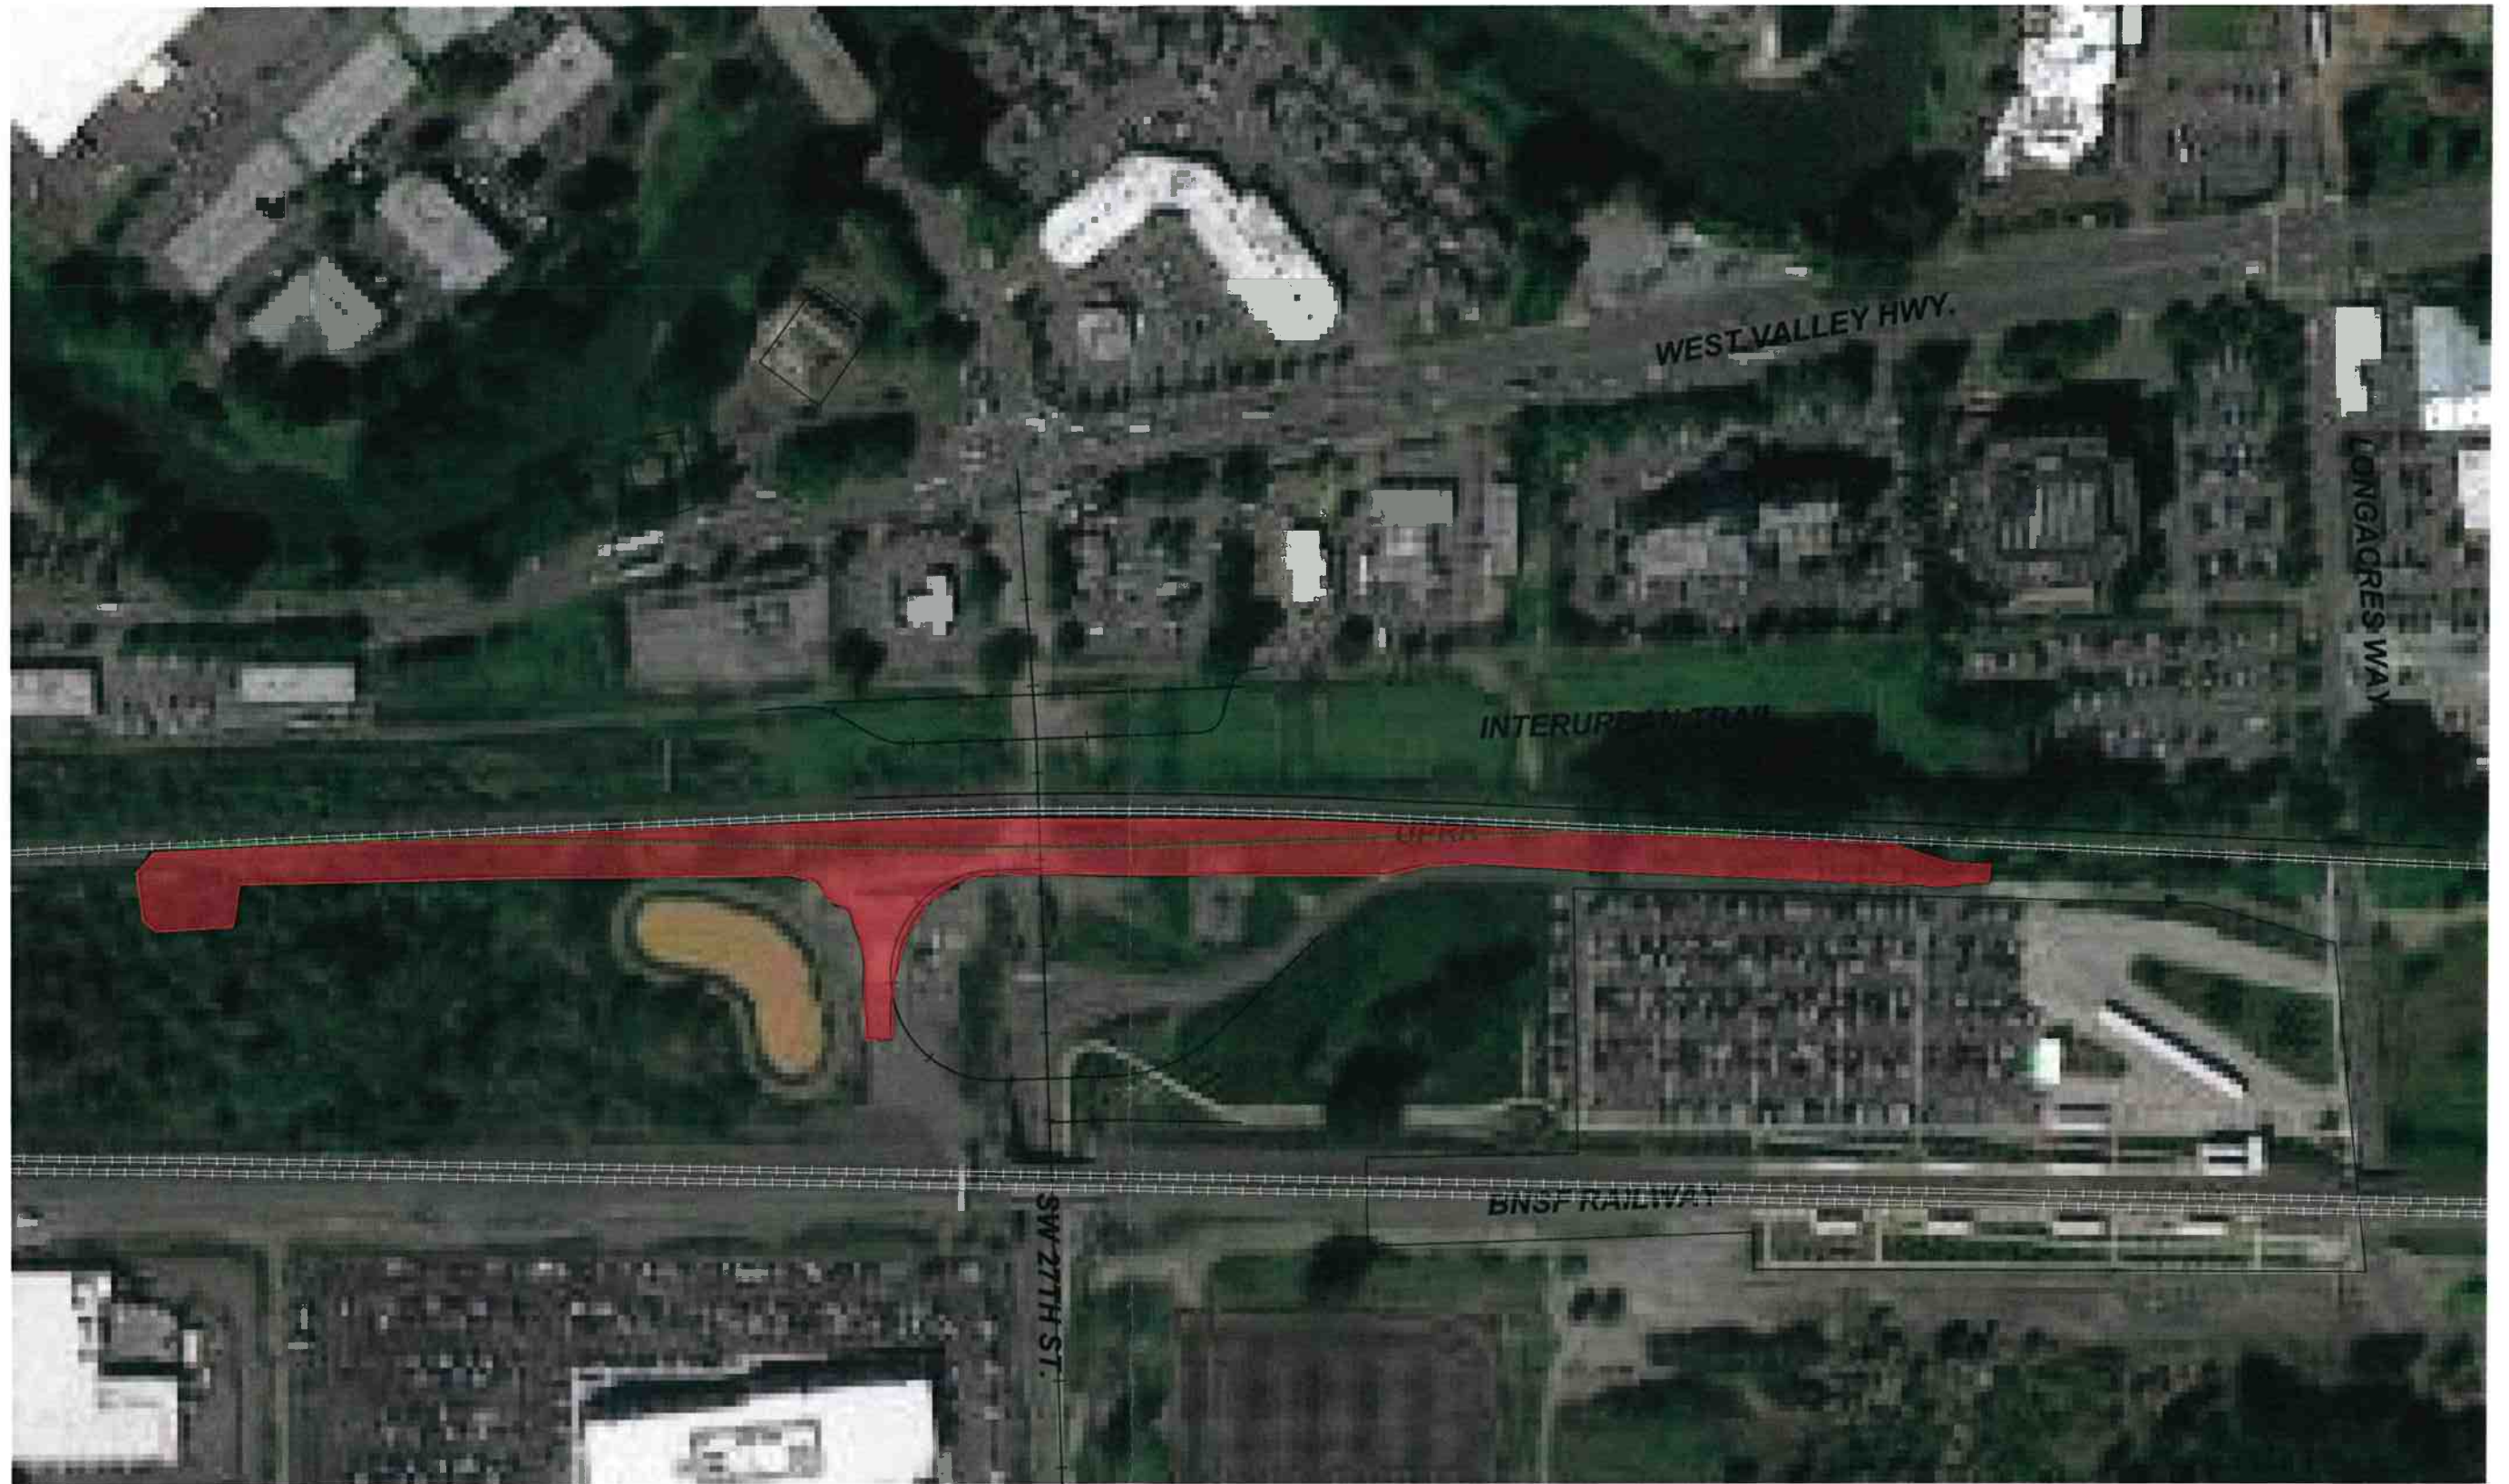

SHOOFLY MAP

STRANDER BLVD/SW 27TH ST EXTENSION PROJECT
TUKWILA, WASHINGTON


LEGEND:



SHOOFLY AREA OF POTENTIAL EFFECT

SEPTEMBER 16, 2017

1" = 200'
scale 200 0 200 400
feet

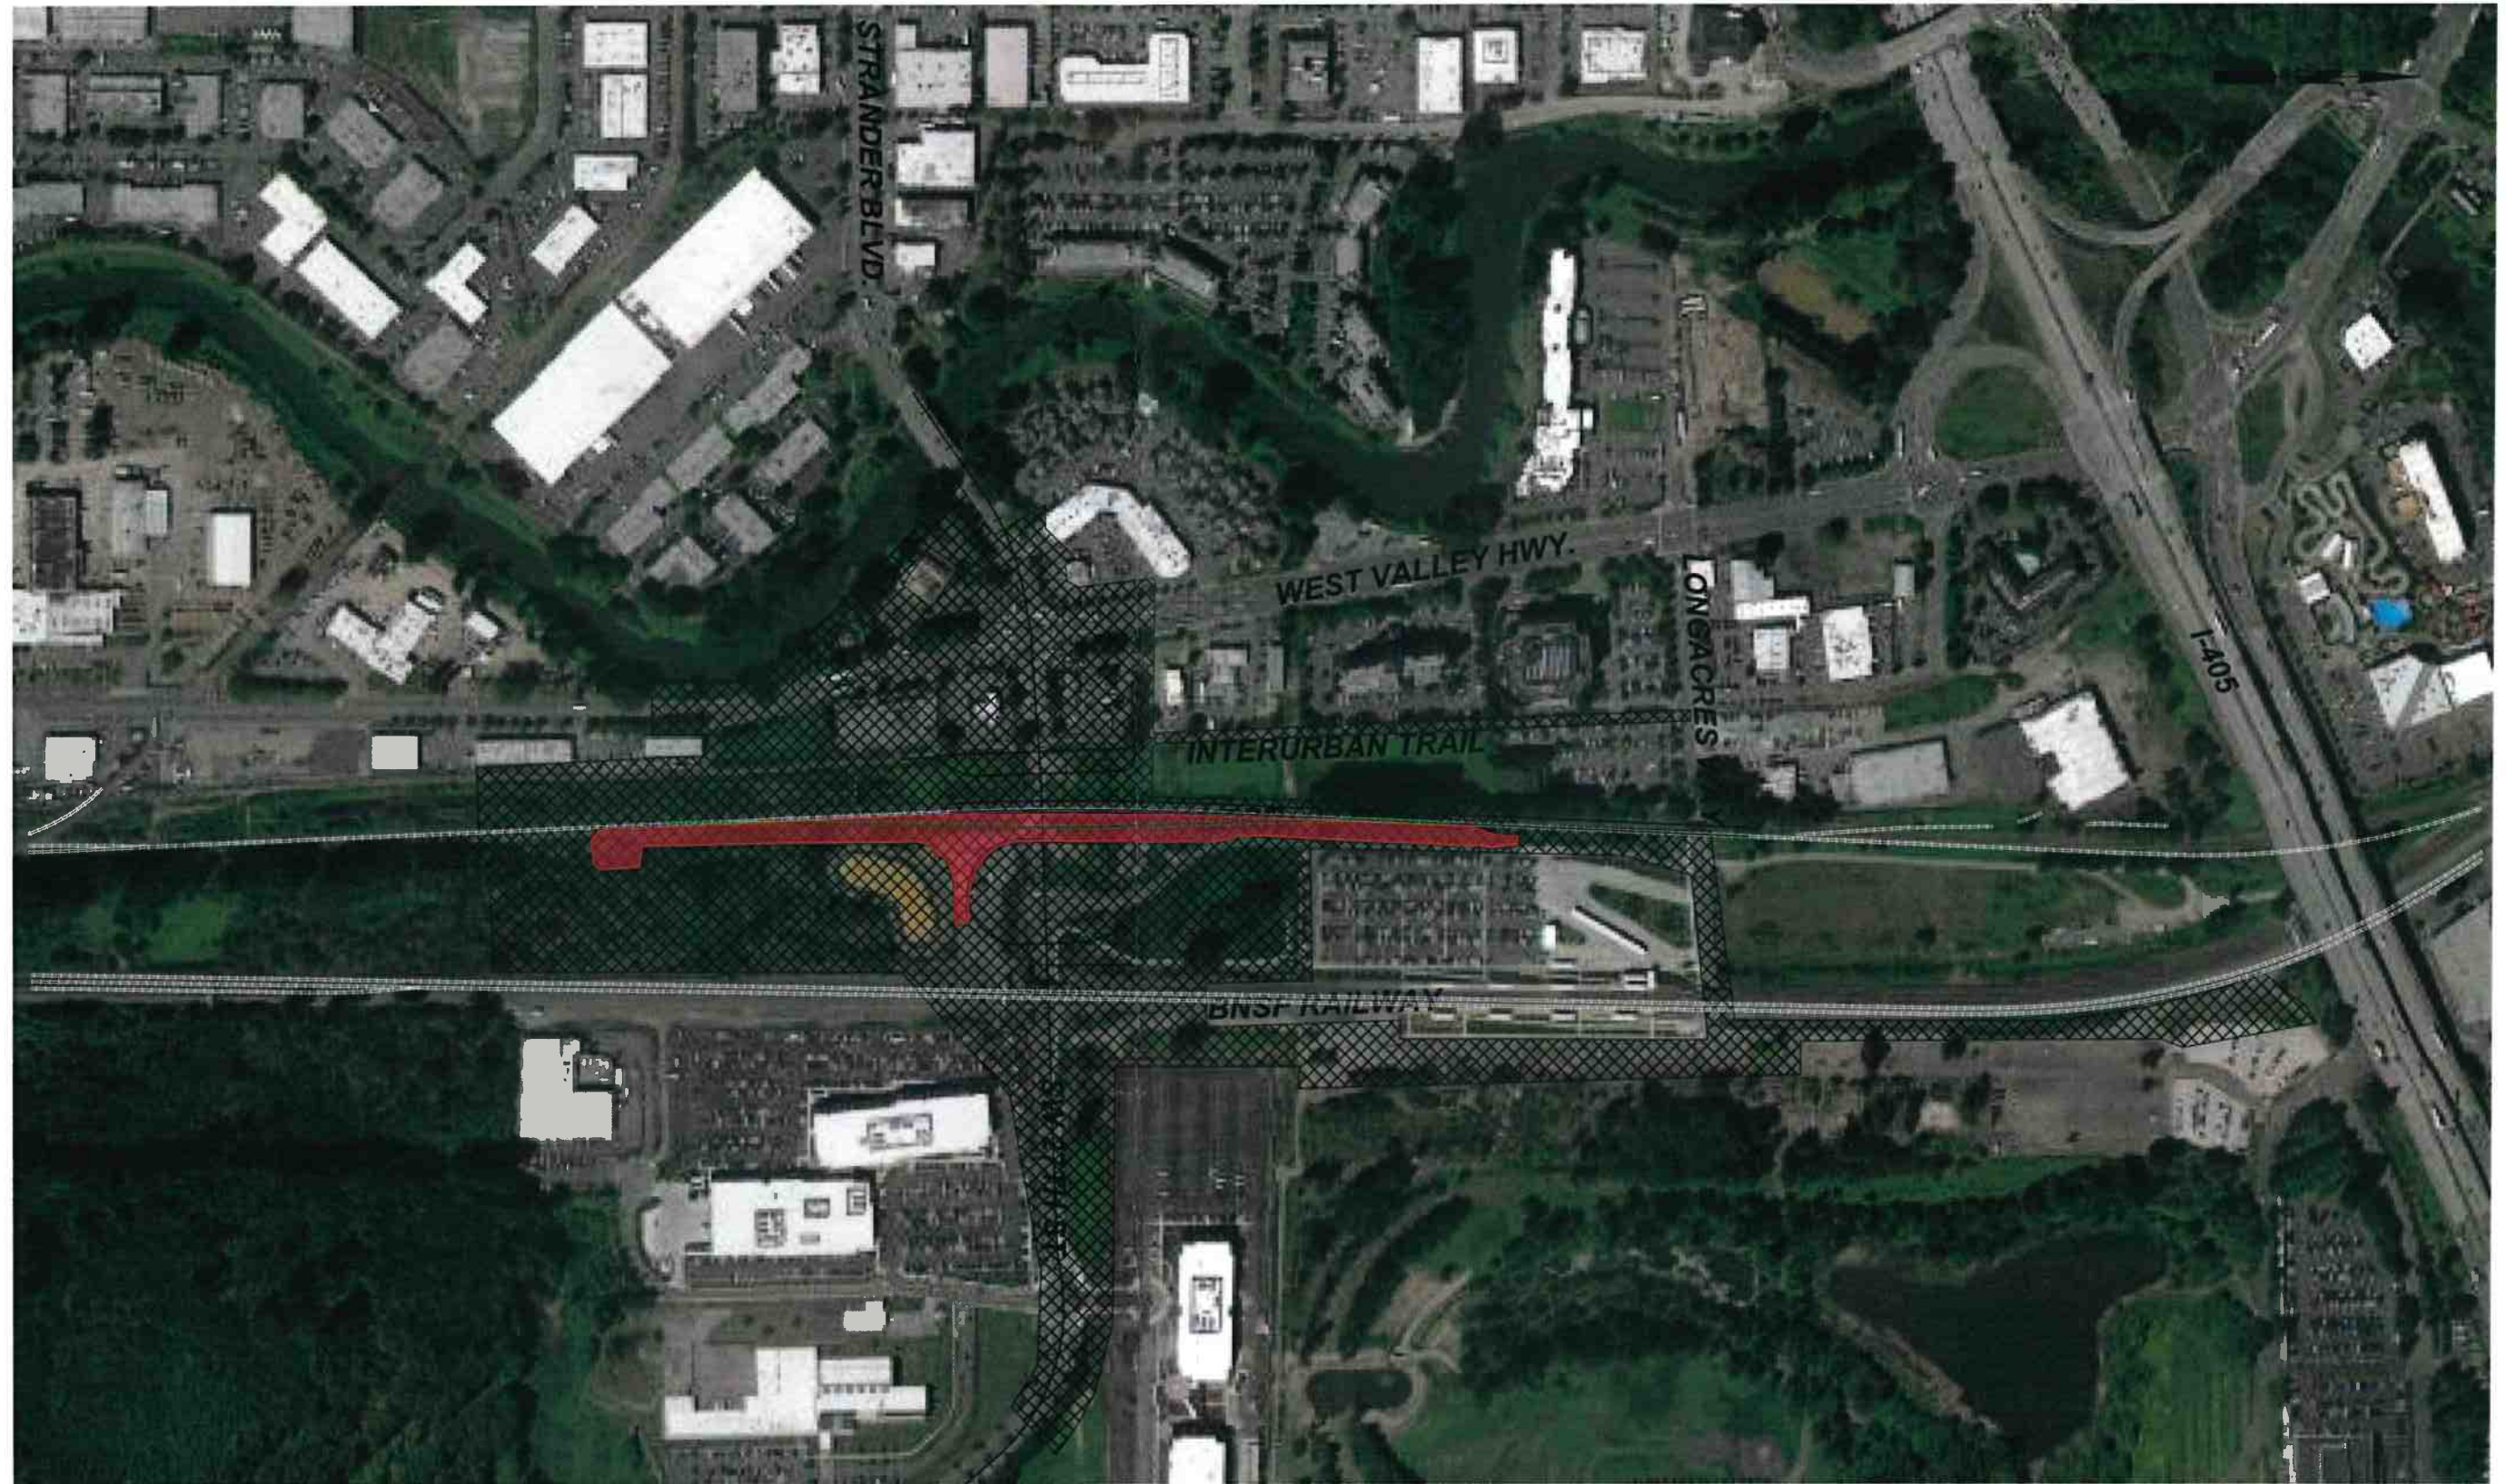

APE MAP

STRANDER BLVD/SW 27TH ST EXTENSION PROJECT
TUKWILA, WASHINGTON

LEGEND:

-  AREA OF POTENTIAL EFFECT (APE)
-  EXTENT OF SHOOFLY

SEPTEMBER 18, 2017

